

THESE DOCUMENTS REFLECT RECORD DRAWING NOTATIONS, RECEIVED FROM COVER CONSULTING COMPANY INC. RECEIVED SEPTEMBER 11, 2006. VERIFICATION OF CONDITIONS INDICATED BY THESE NOTATIONS HAS NOT BEEN PERFORMED BY C.J.M.W.



date	issue for
3-16-05	BIDS
05-29-06	RECORD DRAWING



**HENDERSON COUNTY, NC**  
 HUMAN SERVICES BUILDING

Copyright 2005  
 Calloway Johnson Moore & West, P.A.

FIRE PROTECTION PLAN  
 FIRST FLOOR

sheet  
**FP2.01**

date: MARCH 16, 2005  
 commission: 04-3020  
 drawn by: MEF

**FIRE PROTECTION PLAN - FIRST FLOOR**


SCALE: 1/16"=1'-0"



FIRE PROTECTION PLAN - SECOND FLOOR

SCALE: 1/16"=1'-0"


FP2.01

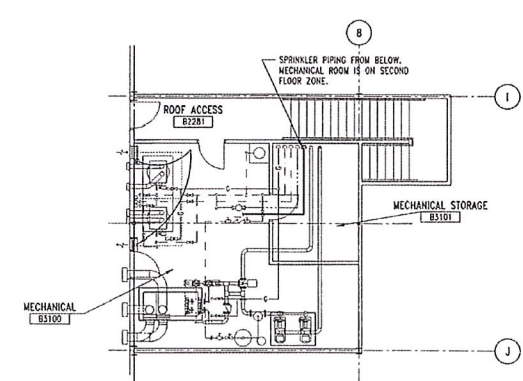

FIRE PROTECTION PLAN  
MECHANICAL ROOM

SCALE: 1/8"=1'-0"

FP2.02

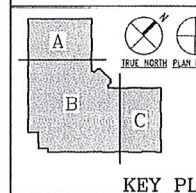

KEY PLAN

THESE DOCUMENTS REFLECT RECORD DRAWING NOTATIONS RECEIVED FROM OWNER CONSTRUCTION COMPANY INC. RECEIVED SEPTEMBER 11, 2006. VERIFICATION OF CONDITIONS INDICATED BY THESE NOTATIONS HAS NOT BEEN PERFORMED BY C.J.M.W.



date	issue for
3-16-05	BIDS
09-29-06	RECORD DRAWING



HENDERSON COUNTY, NC

HUMAN SERVICES BUILDING

Copyright 2005  
Calloway Johnson Moore & West, P.A.

FIRE PROTECTION PLAN  
SECOND FLOOR  
sheet

FP2.02

date: MARCH 16, 2005  
commission: 04-0300  
drawn by: NEF

RECORD DRAWING